

REVISIONS:	
ISSUE	DATE
ISSUED FOR PRICING 02.0	8.2022
SCHEMATIC DESIGN 11.1	0.2022
50% DESIGN DEVELOPMENT 02.0	1.2023
100% DESIGN DEVELOPMENT 04.1	0.2023
50% CONSTRUCTION DOCUMENTS 05.0	8.2023
BID SET 06.0	5.2023
ISSUED FOR FFE BID 10.1	9.2023

# 3'-6" 5'-0" S-19 <sup>¯</sup> M-16 6'-0" 2'-6"

3 FURNITURE ENLARGED PLAN: 152 SAFETY OFFICE 1/4" = 1'-0"

#### <u>LEGEND</u>

EXISTING FURNITURE, BY OWNER NEW FURNITURE

#### PROJECT:

SKOKIE PUBLIC LIBRARY 3rd FLOOR 5215 OAKTON STREET SKOKIE, IL 60077

ARCHITECT:

ANDREW BERMAN ARCHITECT PLLC 77 CHAMBERS STREET NEW YORK, NY 10007 P 212 226 5998

MEP ENGINEER: SALAS O'BRIEN 815 SOUTH WABASH AVENUE CHICAGO, ILLINOIS 60605 P 312 786 4310

LIGHTING DESIGNER: SCHULER SHOOK

363 WEST ERIE, SUITE 400 CHICAGO, ILLINOIS 60604 P 312 944 8230

ACOUSTICAL CONSULTANT:


THRESHOLD ACOUSTICS LLC 141 WEST JACKSON BLVD, SUITE 2080 CHICAGO, ILLINOIS 60604 P 312 386 1400

### SHEET TITLE: FURNITURE PLAN: **GROUND FLOOR**

DRAWN: SEAL:

SCALE: AS NOTED DATE: 06.05.2023 HY CHECKED: AB, AM SHEET NO .:


l-100.00

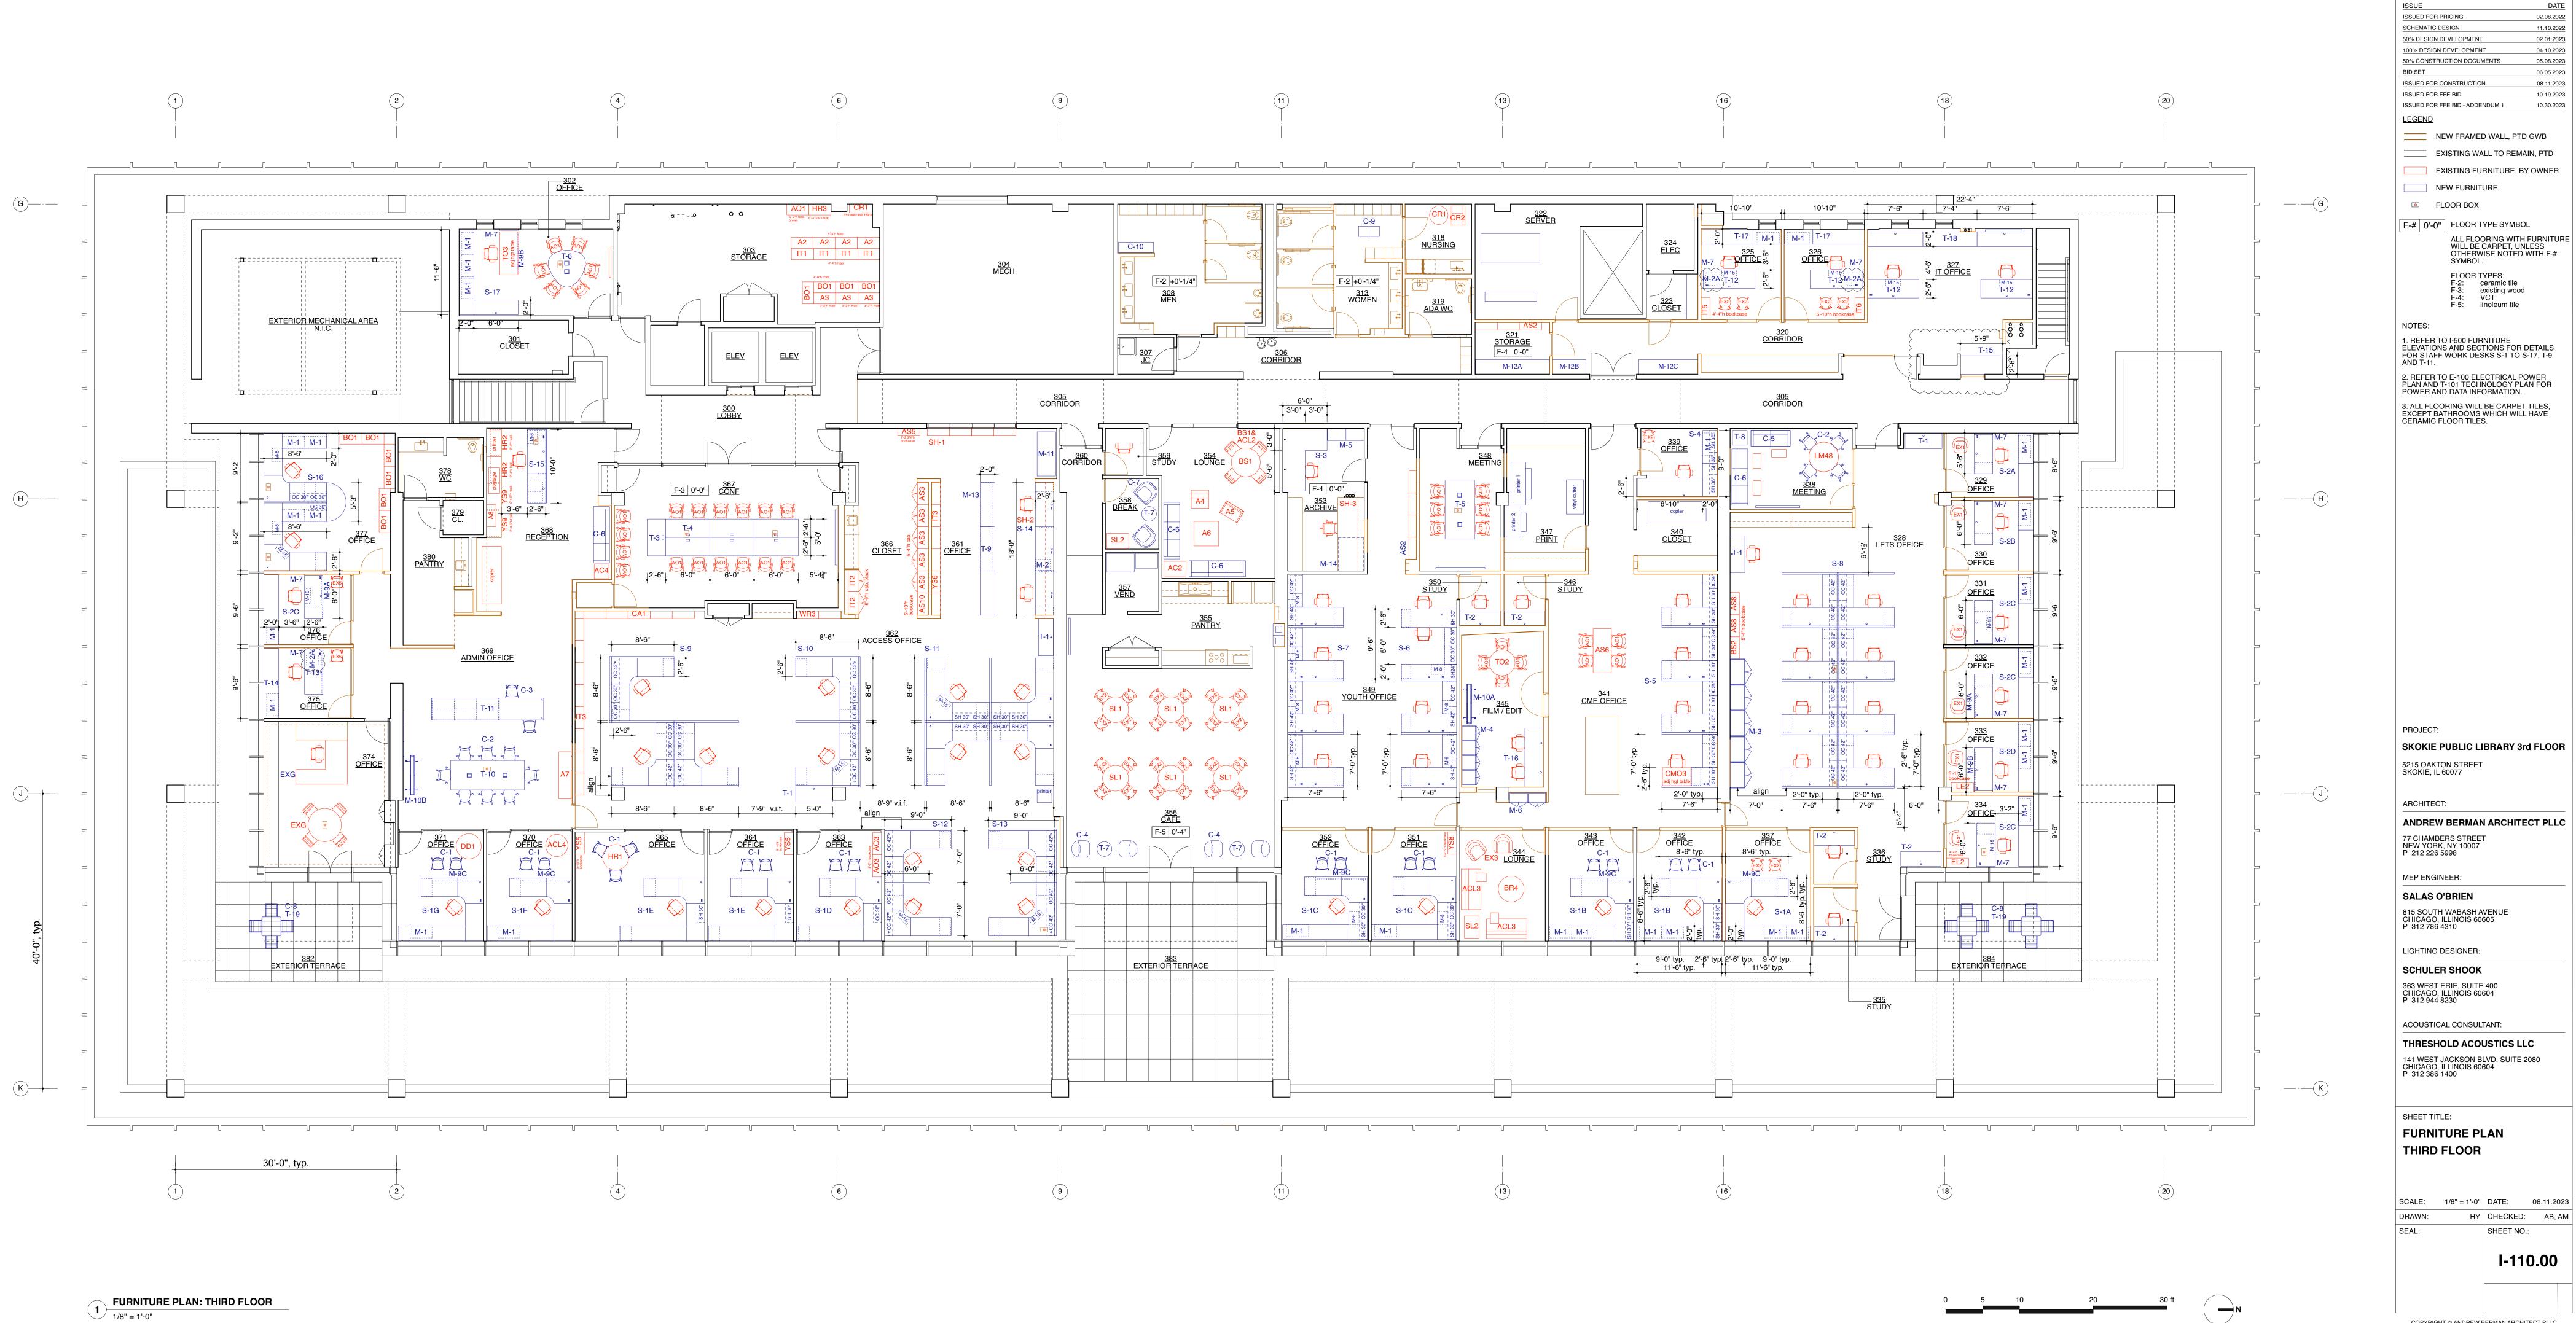

**1** 1/8" = 1'-0"

**REVISIONS:** 

COPYRIGHT © ANDREW BERMAN ARCHITECT PLLC

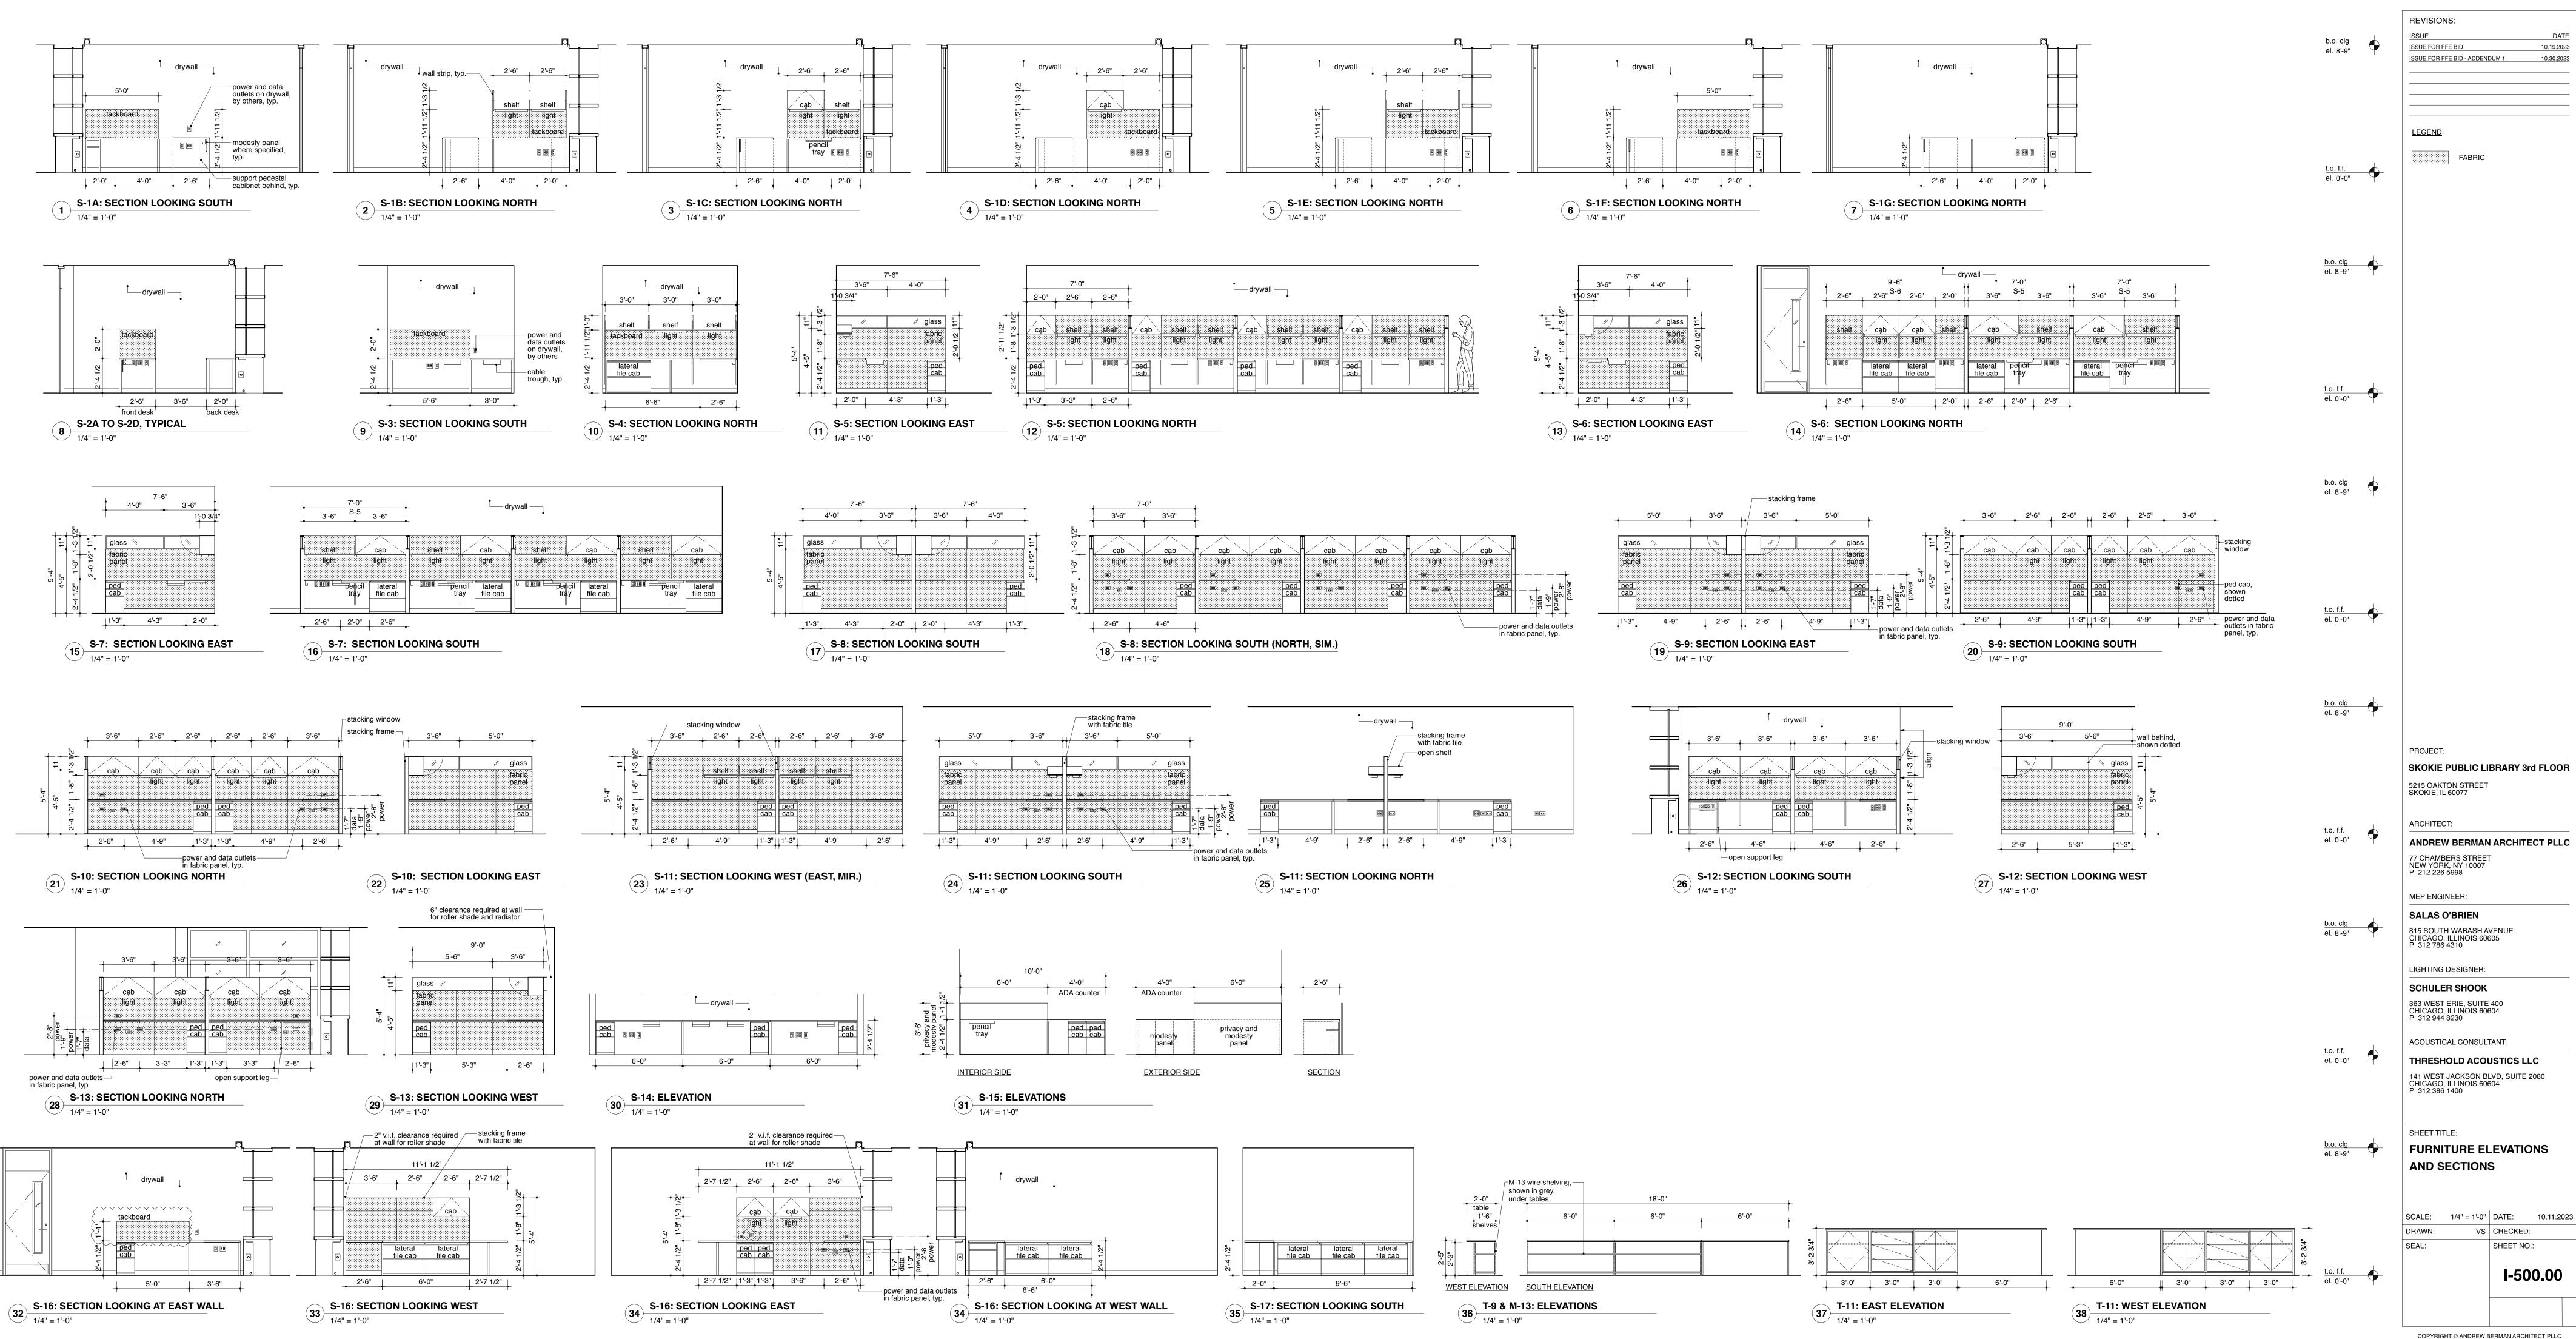



GE	NERAL ELEC	TRICAL SYMBOLS		Ρ	OWE	ER DEVICE SYMBOL
	CONDUIT RUN CONCEALED	ARROWHEAD DENOTES HOMERUN TO	WALL	FLOOR BOX 1	POKE- HROUGH	
	CONDUIT RUN CONCEALED	PANELBOARD. SLASH LINES INDICATE QUANTITY OF WIRE; NEUTRAL WIRE SHOWN AS A LONG LINE, PHASE WIRES AND	₽	<b>⊡⊖</b>	•	DUPLEX RECEPTACLE
	CONDUIT RUN EXPOSED ON CEILING OR WALL	SWITCH LEGS SHOWN AS SHORT LINES, AND GROUND WIRE SHOWN AS A LONG LINE WITH A DOT.	<del>i i i i i</del>	<b>B</b> <del>OO</del>	•	DOUBLE DUPLEX RECEPTACLE
— x —	CONDUIT, WHERE "X" IS THE	E TYPE OR FUNCTION OF CONDUIT.	÷	•	•	DUPLEX RECEPTACLE – SPLIT WIRED
	"C" INDICATES CLOCK "CO" INDICATES CONDUIT "CTV" INDICATES CCTV	"S" INDICATES SOUND ONLY "T" INDICATES TELEPHONE "TVA" INDICATES TELEVISION ANTENNA	ф	∎⊖	⊛⊖	SINGLE RECEPTACLE
	"D" INDICATES DATA "FA" INDICATES FIRE ALAI "I" INDICATES INTERCOM	"TVC" INDICATES CABLE TELEVISION			<b>7</b>	COMBINATION DUPLEX RECEPTACLE TELEPHONE/ DATA SYSTEMS OUTLET
		V" INDICATES LOW VOLTAGE			<b>700</b>	COMBINATION DOUBLE DUPLEX RECEPTACLE TELEPHONE/ DATA SYSTEMS OUTLET
•	CONDUIT STUBBED UP		Ð		00	SPECIAL RECEPTACLE – NEMA TYPE AS IND
•	CONDUIT STUBBED DOWN		<sub>ا</sub> کھ	<b>e%</b>	<b>e</b>	JUNCTION BOX WITH FLEXIBLE CONDUIT AND EQUIPMENT OR FURNITURE SYSTEM POWER
L	FLEXIBLE CONDUIT		₩P ×X	ADJA	CENT LET	TTERS IN THE SYMBOLS ABOVE INDICATE THE
XX	CONDUIT TERMINATION: "CS" INDICATES CAP AND "GB" INDICATES GROUNDIN "IB" INDICATES INSULATIN "TB" INDICATES TERMINAL	IG BUSHING IG BUSHING		"IG" "TVS"	INDICATE INDICATE INDICATE INDICATE INDICATE	ES CHILD RESISTANT (SAFETY TYPE) ES RECEPTACLE FED BY EMERGENCY CIRCUIT ES RECEPTACLE IS EXPLOSION PROOF ES RECEPTACLE HAS GROUND FAULT CIRCUIT ES RECEPTACLE HAS ISOLATED GROUND ES RECEPTACLE HAS TRANSIENT VOLTAGE SUR
	CONDUIT SEAL					ES RECEPTACLE HAS WATERPROOF COVER ES RECEPTACLE CIRCUIT NUMBER
	MULTI-OUTLET ASSEMBLY		•	DUPL	EX RECE	PTACLE MOUNTED ABOVE COUNTER TOP
	WIREWAY		ю	CLOC	K OUTLE	T RECEPTACLE
	CABLE TRAY		ф	CLOC	K OUTLE	T AND CLOCK FOR INTEGRATED CLOCK SYSTE
	BUSWAY (BUSDUCT)		₽€USB	DUPL	EX RECE	PTACLE WITH (2) USB PORTS
====]====	UNDERFLOOR DUCT SYSTEM: —— INDICATES POWER	R DUCT	HO USB	OUTL	ET WITH	(4) USB PORTS
	INDICATES TELEP INDICATES SYSTE		TC	TIME	CLOCK	
		LOCATION OF DIFFERENT TYPES NS TO UNDERFLOOR DUCT SYSTEM.	<b>PC</b>	PHOT	OCELL	
РВ	PULL BOX		S Hos XX XX	) CEILI	NG OR W	VALL MOUNTED OCCUPANCY SENSOR
Û	JUNCTION BOX- EXPOSED	DR IN CEILING			FIRE	E ALARM SYMBOLS
Ю	JUNCTION BOX - WALL MO	JNTED	HS	FIRE	ALARM N	MANUAL PULL STATION
H®	JUNCTION BOX FOR HAND	RYER CONNECTION - WALL MOUNTED	SD	SMO	KE DETEC	CTOR
	JUNCTION BOX WITH FLEXIB FINAL CONNECTION TO EQUI		D	HEAT	DETECTO	DR
PDQ 13	EQUIPMENT IDENTIFICATION	AG	s	VOICI	e speake	ER
			KSV	VOICE	E SPEAKE	ER WITH VISUAL ALARM
			κv	VISU	AL STROE	BE
			HAV	AUDI	BLE GENE	ERAL ALARM WITH VISUAL STROBE
			HRA	REMO	DTE INDIC	ATOR LIGHT FOR SMOKE DETECTOR
			A	AUDI	BLE GENE	ERAL ALARM
			DGP	FIRE	ALARM T	RANSPONDER PANEL
L	1		1	I		

BOLS	POWER EQUIPMENT SYMBOLS		LIGHTING SYN	BOLS		SECURITY SYMBOLS	MOUNTIN		
	SURFACE MOUNTED DISTRIBUTION PANELBOARD	F1 1a	2' X 4' LIGHTING FIXTURE. 2' X 2'	-	ю	PUSH-BUTTON STATION "DB" DOORBELL "DR" DOOR RELEASE	MOUNTING HEIGHTS OF ELECTRICAL ABOVE FINISHED FLOOR TO CENTERL A. FIRE ALARM VISUAL DEVICES		
	RECESSED MOUNTED BRANCH CIRCUIT PANELBOARD		LIGHTING FIXTURE. 1' X 4'	LIGHTING FIXTURES: "F1" INDICATES LIGHTING FIXTURE		BUZZER	B. FIRE ALARM AUDIO VISUAL DEVIC C. INDIVIDUAL DISCONNECTS AND ST D. GROUPED DISCONNECTS AND STA		
ED	SWITCHBOARDS, DISTRIBUTION PANELBOARDS, MOTOR CONTROL CENTERS,1-HDP-1PANELBOARDS, CABINETS, AND RELATED EQUIPMENT	1a F1 1a	FIXTURE- LENGTH AS INDICATED.		D BELL		E. PANELBOARD OVERCURRENT DEV F. GROUPED UTILITY REVENUE MET G. FIRE ALARM PULL STATIONS		
	INDICATES LEVEL ON WHICH PANEL IS LOCATED – G, B, 1, 2, ETC.		WALL MOUNTED LINEAR LIGHTING FIXTURE- LENGTH AS INDICATED.	"a" INDICATES SWITCH CONTROL. SHADING OF LIGHTING FIXTURE OR "E" INDICATES LIGHTING FIXTURE CONNECTED	СН СНІМЕ		REFER TO ARCHITECTURAL DRAWING RECEPTACLES, TELE/DATA DEVICES, NOTE OTHERWISE.		
ET CEPTACLE	INDICATES TYPE, CODED AS FOLLOWS:	CODED AS FOLLOWS:							
et Pe as indicated	"C" CRITICAL OR COMPUTER "L" 208/120V, OR 208V "D" DISTRIBUTION "MCC" MOTOR CONTROL CENTER "E" EMERGENCY "P" POWER "H" 480/277V, OR 480V "Q" EQUIPMENT		LED LIGHTING FIXTURE 2' X 4' LIGHTING FIXTURE			CLOSED CIRCUIT TELEVISION CAMERA	NOTE: ABBREVIATIONS ARE ALPHABETIC		
NDUIT AND FINAL	"ISP" ISOLATION "R" RECEPTACLE "K" KITCHEN "S" STANDBY "L" LIGHTING "SWBD" SWITCHBOARD "XR" X-RAY	F1 E1 F1 E1 ⊢●──	CONNECTED TO EMERGENCY CIRCUIT. LINEAR LIGHTING FIXTURE CONNECTED TO EMERGENCY CIRCUIT.		ES	ELECTRIC STRIKE	LISTED BY DESCRIPTION.           ABBREV.         DESCRIPTION           AFF         ABOVE		
CATE THE FOLLOWING:	AS AS" INDICATES AMPERE RATING OF SWITCH		INCANDESCENT, HID, OR LED LIGHTING FIXTURE CONNECTED TO EMERGENCY CIRCUIT.		DC	DOOR CONTACT	ACL ACROSS THE LINE ALM ALARM AC ALTERNATING CURRENT A AMPERE		
	AS/AF	F10_0E2	BATTERY PACK, EMERGENCY LIGHTING UN	IIT	MS	MOTION SENSOR	AMP AMPERE AIC AMPERES INTERRUPTING CAF AL ALUMINUM ANN ANNUNCIATOR		
CIRCUIT INTERRUPTER IND TAGE SURGE SUPPRESSION	MAGNETIC MOTOR STARTER - NEMA SIZE AS INDICATED	<u> </u>	REMOTE HEAD CONNECTED TO BATTERY	PACK.		COMMUNICATIONS SYMBOLS	ATS AUTOMATIC TRANSFER SWITC BAL BALLAST BR BRANCH		
OVER	AS AS "INDICATES AMPERE RATING OF SWITCH		TRACK LIGHTING "#X" INDICATES INSCRIPTION, ARROWS, A		TTC	TELEPHONE TERMINAL CABINET         FLOOR POKE       SUBSCRIPT INDICATES THE FOLLOWING FOR BELOW	BRKR BREAKER BGB BUILDING GROUND BOX CAB CABINET		
ТОР	Image: Weiter       T     TRANSFORMER	⊢⊗ <sup>#3</sup> E3	FACED, AS SHOWN BELOW. SHADED QUA DIRECTION OF LIGHTED FACES. "#1" FIRE ESCAPE	DRANTS INDICATES	WALL	BOX THROUGH WALL MOUNTED OUTLETS, (U.N.O.): "H" HANDICAP MOUNTED AT 48" A.F.F. "P" PAY PHONE MOUNTED AT 54" A.F.F.	CATV CABLE TELEVISION C.B. CIRCUIT BREAKER CCT CIRCUIT CCTV CLOSED CIRCUIT TELEVISION		
CK SYSTEM.	BGB BUILDING GROUND BOX	$ \begin{array}{c} \hline \\ H \\ \hline \\ H \\ \hline \\ E \\ \hline \\ \hline \\ E \\ \hline \\ \hline \\ E \\ \hline \\ \hline$	$ \begin{array}{cccccccccccccccccccccccccccccccccccc$	"#4"       FIRE ESCAPE       "#17/         W       "#5A"       STAIRS       "#18'	"#2A" STAIRS "# 5 "#3" EXIT "# ── "#4" FIRE ESCAPE → "# "#5a" STAIRS → "#	"#16" FIRE ESCAPE "#17A" STAIRS	•	"W" WALL MOUNTED AT 54" A.F.F.       Image: Contract of the second s	CLO CLOSET COAX COAXIAL C.U. COEFFICIENT OF UTILIZATION COMED COMMONWEALTH EDISON
	ST SHUNT TRIP		"#7" FIRE ESCAPE		"#19" FIRE ESCAPE <del>↓</del> "#20A" STAIRS <del>↓</del> "#21" EXIT <del>↓</del>		DUPLEX TELEPHONE OUTLET	COMPANY C CONDUIT CONN CONNECTION CONV CONVENIENCE	
	SPD SURGE PROTECTION DEVICE				"#11A" STAIRS "#2 ISTING "#12" EXIT	PE "#23A" STAIRS ==== "#24" EXIT =====	Д	■ DATA SYSTEMS OUTLET	CU COPPER CUH CABINET UNIT HEATER CT CURRENT TRANSFORMER HZ HERTZ (CYCLES/SECOND)
	CM CUSTOMER METER	H⊗ #3E E3	"#13" EXIT – RECESSED			EX OUPLEX DATA SYSTEMS OUTLET	DC DIRECT CURRENT DS DISCONNECT SWITCH DPDT DOUBLE POLE DOUBLE THRO DPST DOUBLE POLE SINGLE THRO		
	EMERGENCY POWER OFF MUSHROOM PUSHBUTTON CONTROL STATION	1€1 <sup>#21E</sup> 5 3₩ XXa				Image: Combination telephone/ data systems outlet       T/D     D     JUNCTION BOX WITH FLEXIBLE CONDUIT AND FINAL EQUIPMENT OR FURNITURE SYSTEM CONNECTION.	DO DRAWOUT DT DUSTTIGHT ELEC ELECTRIC		
DLS		\$ 	"a" INDICATES LIGHTS CONTROLLED "D" INDICATES DIMMER SWITCH "K" INDICATES KEY OPERATED "LV" INDICATES LOW VOLTAGE	ICATES DIMMER SWITCH "WP" INDICATES WEATHERPROOF ICATES KEY OPERATED "2P" INDICATES 2 POLE	₩₩	EQUIPMENT OR FURNITURE SYSTEM CONNECTION. SUBSCRIPTS INDICATE THE FOLLOWING: "T" - TELEPHONE "D" - DATA SYSTEMS "T/D" - COMBINATION TELEPHONE/ DATA SYSTEMS	EWC ELECTRIC WATER COOLER EWH ELECTRIC WATER HEATER EM EMERGENCY EMT ELECTRIC METALLIC TUBING (THIN WALL CONDUIT)		
		_	"MC" INDICATES MOMENTARY CONTACT "P" INDICATES PILOT LIGHT "TH" INDICATES THERMAL OVERLOAD	"3P" INDICATES THREE POLE "3W" INDICATES THREE—WAY "4W" INDICATES FOUR—WAY	HD C	) INTERCOM, WALL OR CEILING MOUNTED	EQ ÉQUIPMENT EUH ELECTRIC UNIT HEATER EX EXISTING EP EXPLOSION PROOF		
			PROTECTION		HS S	SPEAKER, WALL OR CEILING MOUNTED	FPB FAN POWERED BOX FA FIRE ALARM FDC FIRE DEPARTMENT CONNECT FB FLOORBOX FLUOR FLUORESCENT		
							FMC FLEXIBLE METALLIC CONDUIT F FUSE F.S. FUSED SWITCH GEN GENERATOR		
							GRD GROUND GFI GROUND FAULT INTERRUPTE GHW GALVANIZED HEAVYWALL STE		
							CONDUIT HV HIGH VOLTAGE HP HORSE POWER INC INCANDESCENT		
							IC INTERRUPTING CAPACITY IMC INTERMEDIATE GRADE CONDU JB JUNCTION BOX		
							KW KILOWATT KWH KILOWATT-HOUR		

# **1**<u>ELECTRICAL SYMBOL LIST</u> N.T.S.

		REVISIONS: ISSUE 50% DESIGN DEVELOPME 100% DESIGN DEVELOPM 50% CONSTRUCTION DO	IENT	DAT 02.01.202 04.10.202 05.08.202
		<u>SO% CONSTRUCTION DO</u> BID SET ISSUE FOR CONSTRUCTI ISSUE FOR FFE BID		05.08.202 06.05.202 08.11.202 10.19.202
NG HE	IGHTS			
LINE, UNLESS FARTERS ARTERS ICES ERS 5 FOR MOUNTI	BE AS LISTED BELOW NOTED OTHERWISE: 80" 60" > 12" < 72" > 12" < 72" > 30" 48" NG HEIGHTS OF SWITCHES, UNLESS			
EVIATIO	ONS			
CALLY				
ABBREV KVA KO LTG LS LV MH MFR MV MERC. CH MTR MCC MTD NEC NEUT NC	<ul> <li><u>DESCRIPTION</u></li> <li>KILOVOLT-AMPERE</li> <li>KNOCKOUT</li> <li>LIGHTING</li> <li>LOUD SPEAKER</li> <li>LOW VOLTAGE</li> <li>MANHOLE</li> <li>MANUFACTURER</li> <li>MULTI VAPOR</li> <li>MERCURY VAPOR</li> <li>MOTOR</li> <li>MOTOR CONTROL CENTER</li> <li>MOUNTED</li> <li>NATIONAL ELECTRICAL CODE</li> <li>NEUTRAL</li> <li>NORMALLY CLOSED</li> </ul>			
NO NIC NTS PNL PH PT PWR PRI PROT. PA PB RT RECP RC	NORMALLY OPENED NOT IN CONTRACT NOT TO SCALE PANEL PHASE POTENTIAL TRANSFORMER POWER PRIMARY PROTECTION OR PROTECTIVE PUBLIC ADDRESS PULL BOX RAINTIGHT RECEPTACLE REMOTE CONTROL			
R REL SEC SC W SPST SPDT SPKR SPEC SS STA S SWBD SWBD SWGR	RESISTANCE RELOCATE SECONDARY SHORT CIRCUIT SINGLE POLE SINGLE POLE SINGLE THROW SINGLE POLE DOUBLE THROW SPEAKER SPECIFICATION STAINLESS STEEL STATION SWITCH SWITCHBOARD SWITCHGEAR	PROJECT: SKOKIE PUBLIC 5215 OAKTON STR SKOKIE, IL 60077		
SYM SYS TC TEL TEL.CL. TTC ON TV TERM. TX T TL UL UL UNG UH	SYMMETRICAL SYSTEM TERMINAL CABINET TELEPHONE	ARCHITECT: ANDREW BERMAN 77 CHAMBERS STR NEW YORK, NY 100 P 212 226 5998 MEP ENGINEER: SALAS O'BRIEN 815 SOUTH WABAS CHICAGO, ILLINOIS P 312 786 4310	REET 007	
R UNO EL VP VT	UNLESS NOTED OTHERWISE VAPORPROOF VAPORTIGHT	LIGHTING DESIGNER	₹:	
V VA WT IT WP XR XRL XRW	VOLT VOLT-AMPERE WATERTIGHT WATT WEATHERPROOF EXISTING TO BE REMOVED EXISTING TO BE RELOCATED EXISTING TO BE REWIRED	SCHULER SHOO 363 WEST ERIE, SI CHICAGO, ILLINOIS P 312 944 8230 ACOUSTICAL CONS THRESHOLD AC 141 WEST JACKSOI CHICAGO, ILLINOIS P 312 386 1400	UITE 400 60604 ULTANT: OUSTICS LI	
		SHEET TITLE: ELECTRICAL SY	MBOL LIST	
		SCALE:	DATE:	
		DRAWN: SEAL:	CHECKED: SHEET NO. E-001	:

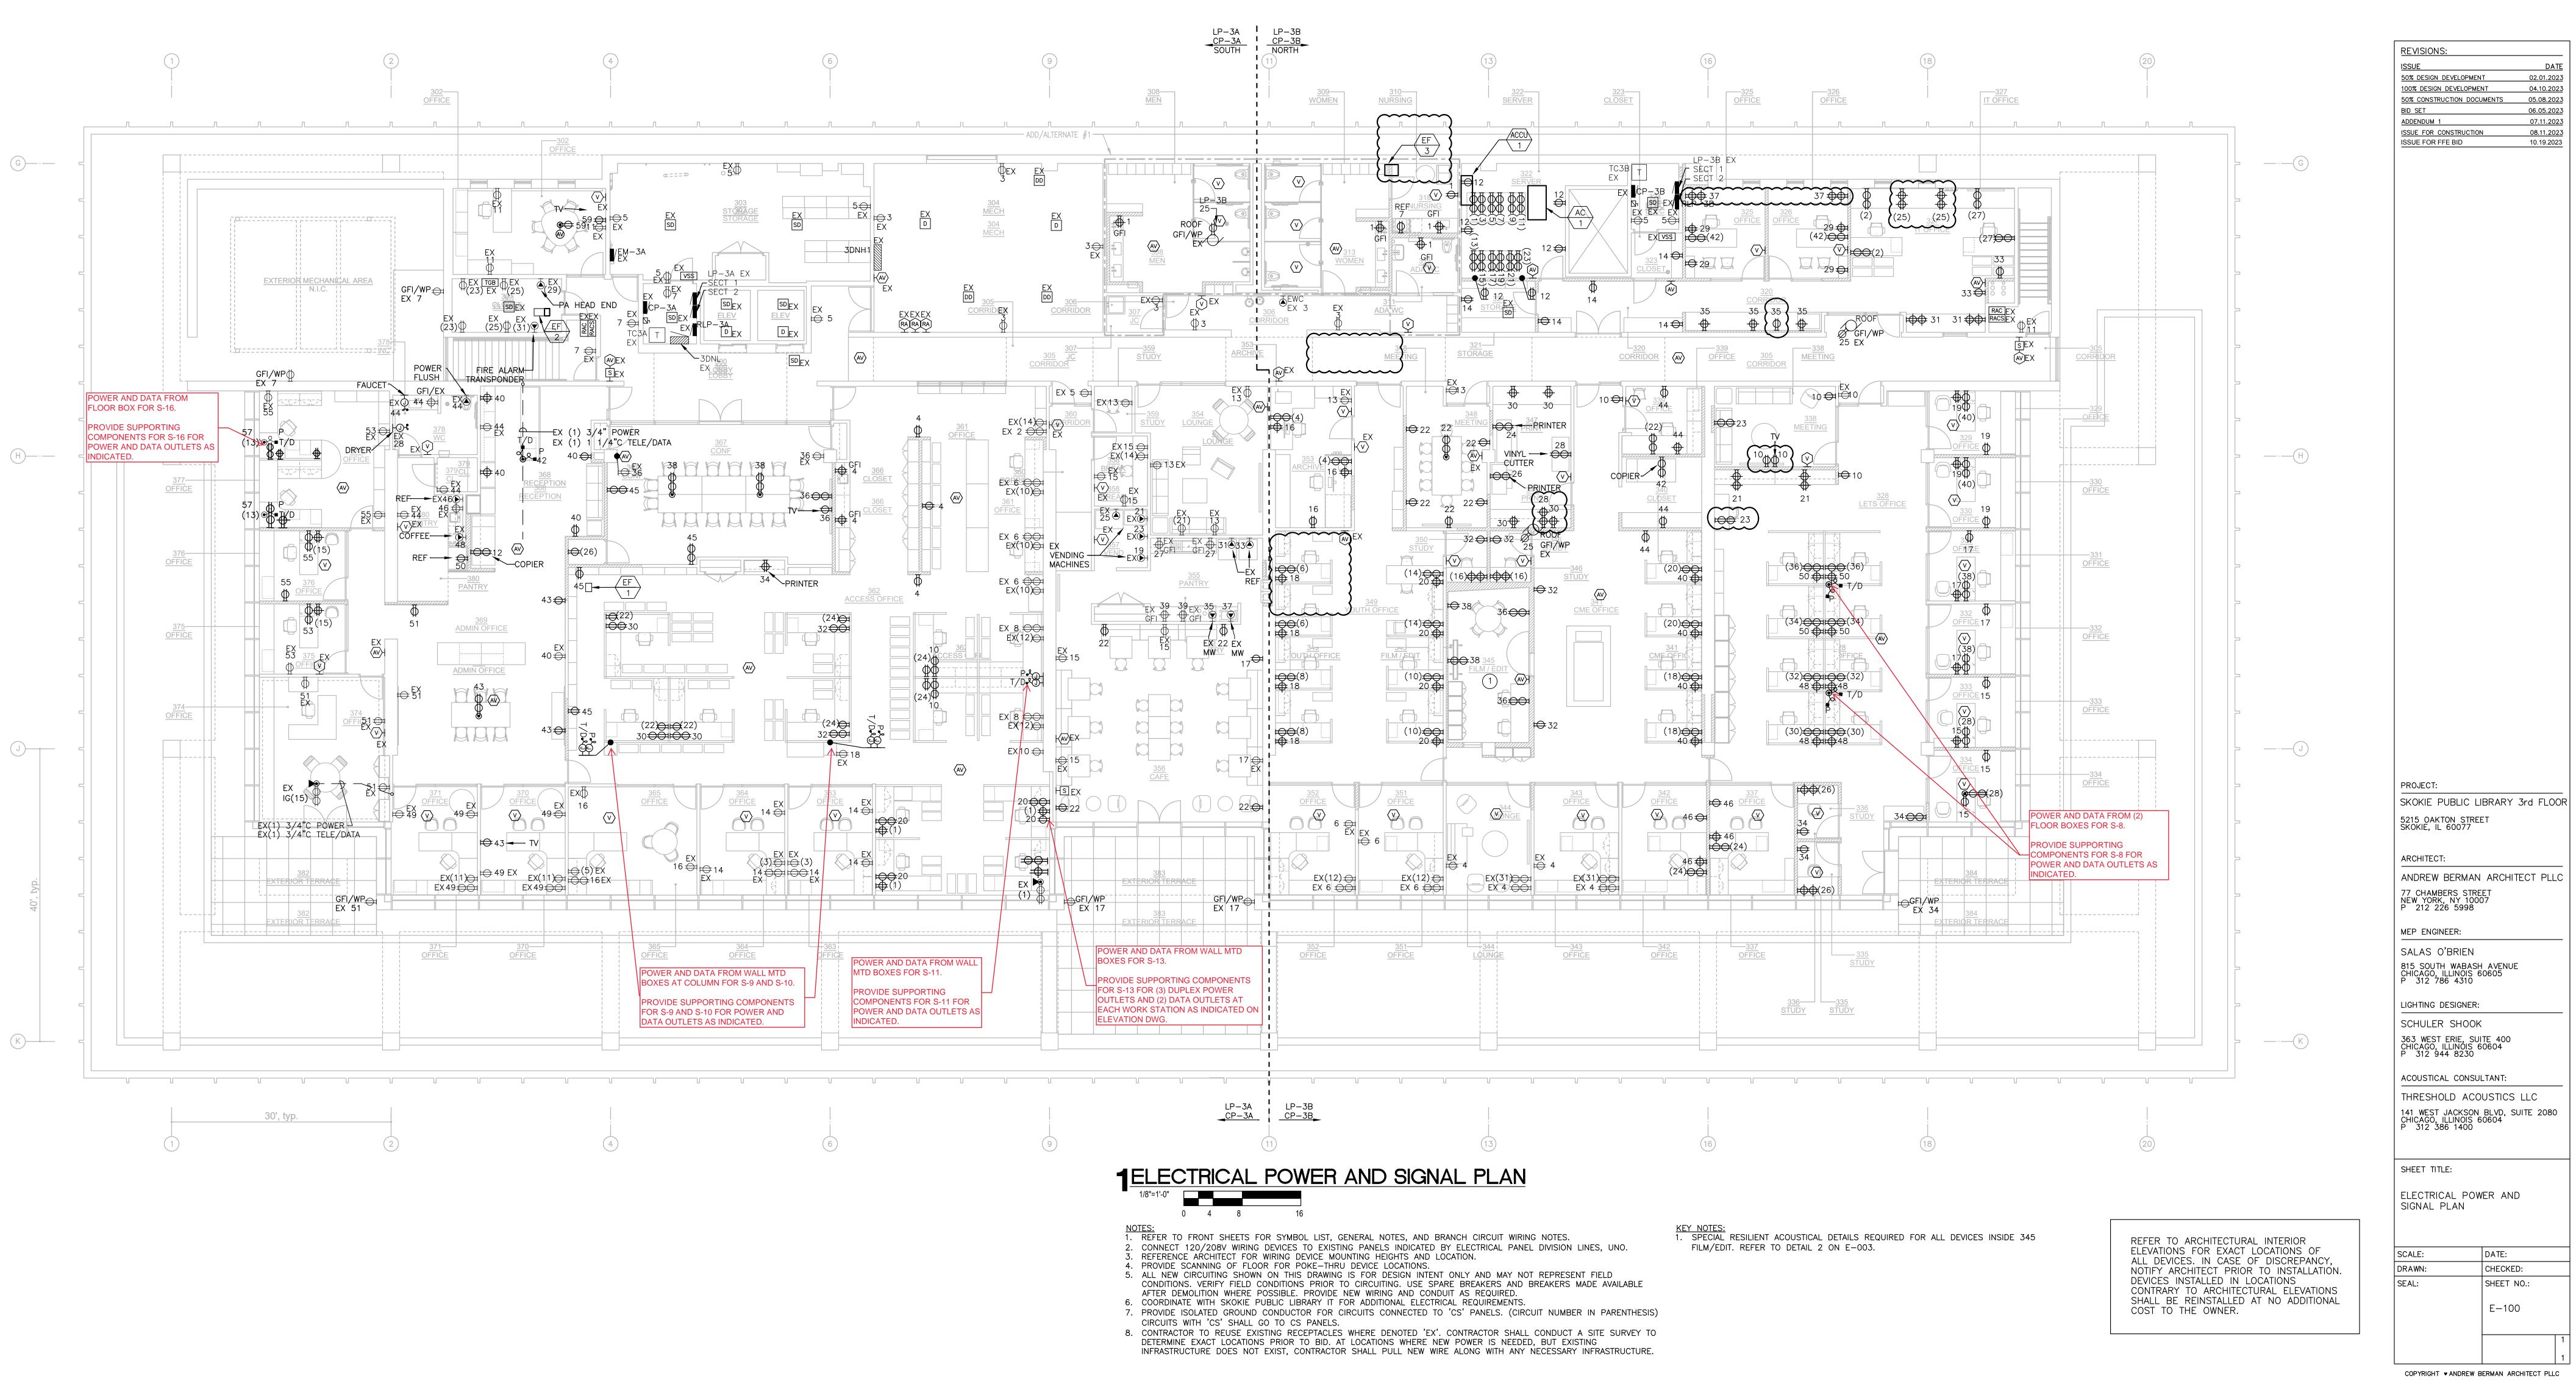

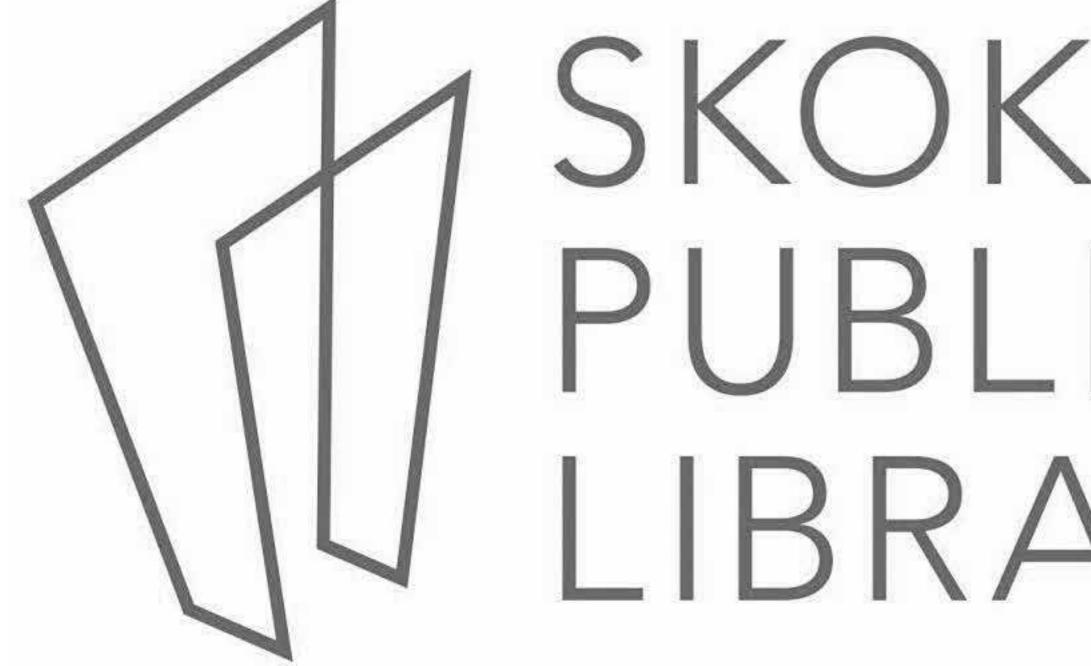

SKOKIE PUBLIC LIBRARY **3RD FLOOR TECHNOLOGY SET** 

# AUDIO-VISUAL FUNCTION SUMMARIES & EQUIPMENT LISTS

### **AV REQUIREMENTS**

- Final Design1. The AV installer is required to complete the final design based upon the intent and major components listed herein.
- 2. All work proposed from these documented shall be complete and fully functional systems. Displays & Project Devices: 1. All displays shall be provided commercially rated or with an extended warranty to be used in a
- commercial environment. 2. All displays shall be rated for use 16-hours per day, 7-days per week unless noted otherwise. 3. Final field coordination of flat panels, projectors, screens, touch panels, or other display
- technology shall be completed by the AV installer. Control systems and user interface
- 6. Final user interface shall be verified with the client during the submittal phase for all touch panels, button controllers, and other control elements.
- The user interface must meet the functionality described in the summary and conform to any known client standards.
- 8. Maps must be provided on the control interface to provide visual indication of input and output locations. 9. Custom user interfaces shall follow AVIXA documented best practices and created to be user
- friendly with minimal training. Input location cords
- 1. End user input location cords will not be listed in the equipment list unless it is fixed within a device (cubby, etc.)
- 2. The installer shall provide a user connection cable for each input location and each input connection type.
- Signal transmission
- 1. All cabling required for the system shall be provided by the AV installer unless noted otherwise. 2. Any network data locations identified to be provided by the Communications installer shall be excluded from the AV installer's scope of work.
- 3. All cabling shall be certified for the intended purpose and fall within the guidelines of the manufacturer of both ends of equipment.
- 4. All digital transport encoders, decoders, baluns, or other required active components shall be
- provided by the AV installer within the base scope of work. 5. All AV and signal transmission exceeding 15-feet shall be converted to a digital UTP cabling svstem.

#### Signal Processing

- 1. All display native resolutions shall be identified for the client and input shall be scaled to that resolution. The following requirements shall be set a baseline standard for all display devices or separate
- processing components that may not be listed in the equipment list: <u>Up/Down Scaling</u>: Horizontal, Vertical, and Diagonal averaging
- De-Interlacing: Motion Adaptive Color Depth: 10-bits
- Chroma Sampling: 4:4:4

<u>Re-Sync</u>: Automatic

1. For all spaces controlled by digital signal processors, the AV installer must provide full

- programming, tuning, balancing, and commissioning.
- Analog, IP, or USB interface shall be confirmed prior to ordering any equipment. Automatic gain shall be configured and a maximum of 6dB noise cancellation used.
- . Microphone muting requirements shall be presented to the client prior to programming for

### acceptance of standard operating procedures.

### **CONFERENCE ROOM 367**

Function Summary				
Use Case	Local Presentation and V	_ocal Presentation and Video Conferencing		
Display	Existing 90" display on w	all		
Input	Existing Mersive Solstice	Pod, Existing OFE PC		
Audio	Existing Overhead Micro	phones, New Ceiling Speakers		
Control	Mfr Remote Control			
Special	AV Rack Moved to New	Closet		
	Eq	uipment Summary		
Manufacturer	Model	Description		
SHARP	OFE (EXISTING)	90" FLAT PANEL DISPLAY		
EXISTING	OFE	WALL MOUNT		
EXISTING	OFE MERSIVE	WIRELESS PRESENTATION DEVICE		
EXISTING	OFE COMPUTER	COMPUTER IN RACK (WIRELESS KEYBOARD KIT)		
QSC	SPA2-60	70V AMPLIFIER		
QSC	AD-C6T-LP	70V CEILING SPEAKER (QTY PER PLANS)		
EXISTING	30 QMINI	EXISTING OFE PTZ CAMERA WITH USB EXTENSION		
EXISTING	EASYUSB MIXER/AMP	EXISTING OFE USB AUDIO BRIDGE		
EXISTING	CEILING MIC	EXISTING OFE CEILING MIC (QTY 2)		
EXISTING	AV RACK	EXISTING AV RACK		
CHIEF	PAC526	AV SPECIALITY BACK BOX		
CRESTRON	HD-TX-4KZ-101	HDBT TRANSMITTER		
CRESTRON	HD-RX-4KZ-101	HDBT RECEIVER		
ATLAS IED	TSD-BB44	4/4 I/O AUDIO DSP (INCLUDE POWER SUPPLY)		

#### **CONFERENCE ROOM 348**

#### Function Summary Use Case Local Presentation and Video Conferencing Display Existing 65" display to be reused Input HDMI input at table, wireless presentation Unified Comunication Soundbar Audio Control Touch Control Panel on table **Special** Soundbar to allow USB connection to bring your own device Equipment Summary Manufacturer Model Description 65" FLAT PANEL DISPLAY BY OWNER VERIFY VERIFY CHIEF LOW PROFILE WALL MOUNT (VERIFY COMPATIBILITY LSTU POLYCOM X50 UNIFIED CONFERENCING SOUNBAR TABLE TOP MOUNTED TOUCH CONTROL PANEL POLYCOM TC8 ICRON RANGER 2311 USB 2.0 EXTENDER HD-TX-4KZ-101 HDBT EXTENDER (TRANSMITTER) CRESTRON HDBT EXTENDER (RECEIVER) HD-RX-4KZ-101 CRESTRON AV SPECIALITY BACK BOX CHIEF PAC526

### CONTINGENCY

Contractor Shall be responsible for any costs associated with the replacement of any existing equipment damaged during the demo scope. For any equipment that is to be re-used, Contractor shall verify, in the presense of the owner, that existing equipment works prior to removal for safe keeping.

### **CONFERENCE ROOM 338**

	F	unc	
Use Case	Local Presentation Only, No		
Display	65" Flat Panel Display		
Input	HDMI Input at Wall plate		
Audio	Internal to Display		
Control	MFR provided remote contro		
Special	N/A		
	E	quip	
Manufacturer	Model		
NEC	ME651	65"	
CHIEF	LSTU	LO	
LEGRAND	39878	HD	
CHIEF	PAC526	AV	

	F	uno	
Use Case	Digital Signage		
Display	55" Flat Panel Display		
Input	Owner Provided Small Fo	orm	
Audio	Internal to Display only		
Control	MFR provided Remote Cont		
Special	N/A		
	Eq	uip	
Manufacturer	Model		
NEC	ME551	55	
CHIEF	LSTU	LC	
BY OWNER	BY OWNER	SN	
	1		

CHIEF

PAC526

	F	unction Summa		
Use Case	Local HDMI presentation			
Display	55" Flat Panel Display			
Input	HDMI input at table			
Audio	Internal to Display only	Internal to Display only		
Control	MFR provided Remote Control			
Special	N/A			
	Eq	uipment Sumn		
Manufacturer	Model			
BY OWNER		55" FLAT PAN		
CHIEF	LSTU	LOW PROFILE		
CHIEF	PAC526	AV SPECIALIT		
CRESTRON	HD-TX-4KZ-101	HDBT TRANS		
CRESTRON	HD-RX-4KZ-101	HDBT RECEIV		

	C	)FF	
		Func	
Use Case	Local HDMI presentatio	n	
Display	55" Flat Panel Display		
Input	HDMI input at table		
Audio	Internal to Display only		
Control	MFR provided Remote Contr		
Special	N/A		
	E	quip	
Manufacturer	Model		
NEC	ME551	55"	
CHIEF	LSTU	LO	
CHIEF	PAC526	AV	
CRESTRON	HD-TX-4KZ-101	HD	
CRESTRON	HD-RX-4KZ-101	HD	

	NUR	SI	
		Func	
Use Case	Casual Watching of TV	Conte	
Display	55" Display		
Input	Smart TV only		
Audio	Internal to Display		
Control	MFR provided remote		
Special	N/A		
	E	quip	
Manufacturer	Model		
SAMSUNG	QN55Q70CAFXZA	55"	
CHIEF	LSTU	LOV	
CHIEF	PAC526	AV	

Paging Speakers are shown on the RCP for reference only. Design by others. Contractor shall refer to documentation by others for exact wiring requirements and other equipment requirements.

# AFTER HOURS WORK

Contractor shall coordinate with owner IT team to determine what work will need to be done after hours on premium time in order to minimize any network downtime. Contractor shall provide any cost related to after hours work as park of the submittal proposal.

	$\bigcap$
1977	
	DV
1	

ction Summary Video Conferencing

pment Summary Description

5" FLAT PANEL DISPLAY

OWPROFILE WALL MOUNT

IDMI PASS THROUGH WALL PLATE

AV SPECIALITY BACK BOX

# CAFE

ction Summary

m Factor PC to run digital signage content

ntrol

ipment Summary

Description

55" FLAT PANEL DISPLAY OW PROFILE FLAT PANEL DISPLAY WALL MOUNT SMALL FORM FACTOR DIGITAL SIGNAGE PLAYER AV SPECIALITY BACK BOX

OFFICE 302

unction Summary

ipment Summary

Description

55" FLAT PANEL DISPLAY OW PROFILE FLAT PANEL DISPLAY WALL MOUNT

V SPECIALITY BACK BOX

HDBT TRANSMITTER (MOUNTED UNDER TABLE)

IDBT RECEIVER (MOUNTED BEHIND DISPLAY)

# **OFFICE 370**

ction Summary

pment Summary

Description

5" FLAT PANEL DISPLAY OW PROFILE FLAT PANEL DISPLAY WALL MOUNT

SPECIALITY BACK BOX

DBT TRANSMITTER (MOUNTED UNDER DESK)

DBT RECEIVER (MOUNTED BEHIND DISPLAY)

# **SING RM 318**

ction Summary

ntent

pment Summary

Description

SMART TV DISPLAY

W PROFILE FLAT PANEL DISPLAY WALL MOUNT SPECIALITY BACK BOX

# PAGING SYSTEM

# CABLING SCOPE & EQUIPMENT LISTS

### CABLING REQUIREMENTS

- Install cable in pathways 1.1. No cabling to be exposed and accessible after installation
- Furniture feeds must be in conduit whip or mesh sleeve 1.2 Visually exposed transition from one pathway to another must be routed in neat bundles 1.3.
- tight to the structure. UTP cable length shall be installed with no length exceeding 275-feet.
- Arrange cable to maintain headroom and present a neat appearance. Route cable, exposed or above accessible ceiling, parallel and perpendicular to walls and
- building structure. Maintain adequate clearance, minimum of 12-inches, between ventilating ducts, piping,
- suspended ceilings, and high temperatures. Provide Velcro straps on all cable bundles - zip-ties are not acceptable
- Service Loops a. Provide 180-inch service loop at all ceiling devices
- b. Provide 24-inch service loop at all wall and floor devices
- Observe proper clearances from power, equipment and lighting. 10. All fiber cabling shall be fusion spliced.

# WIRELESS ACCESS POINTS

Wireless access points shall be provided by the owner and installed by the cabling installer. Enclosures are NOT required for this project

### CONNECTING CORDS AND ADAPTERS

- All switch to patch panel patch cables shall be furnished and installed by the owner.
- Owner Shall determine all colors and lengths of patch cables The installer shall provide the following additional package for startup requirements:
- Qty. 8 3m Fiber Patch Cords Qty. 16 - 5-foot Voice Patch Cords
- Qty. 10 5-foot Data Patch Cords
- Qty. 12 15-foot Data Patch Cords
- Owner shall provide all end point patch cables

### **TELECOMMUNICATIONS BONDING SYSTEM**

Telecommunications equipment and raceways shall be

"Two-Point Test Method."

properly grounded and bonded in accordance with TIA/EIA-607 and the NEC. The telecommunications grounding and bonding system shall be tested with an "Earth Ground Resistance Tester, Amprobe GP-1" using the

STRUCTURED CABLING EQUIPMENT LIST			
Manufacturer	Part Number	Description	
	MDF/IDF/	SERVER ROOM	
CPI	55053-703	2-Post Rack	
Panduit	45RU WMPV45E	NetRunner Vertical Cable Manager	
Panduit	NMF2	2U Horizontal Cable Manager	
Hubbell	HPJ48	48 Port Unloaded FLATPatch Panel	
Corning	CCH-01U	1U Fiber Panel (IDF)	
Corning	CCH-02U	2U Fiber Panel (MDF)	
Corning	CCH-CS24-E4-P00QE	12-Strand Fiber Cassette (FUSION SPLICE)	
FIELD DEVICES			
Hubbell	IFP12	2-Port Keystone Face Plate (Verify Color)	
Hubbell	IFP14	4-Port Keystone Face Plate (Verify Color)	
Hubbell	ISB2	2-Port Keystone Surface Box	
		Surface Mount Box	
Hubbell	HXJ6	8P8C Connector - Color Coded Per Device	
	C	ABLING	
Hubbell	C6RP	Category 6 Cable (Plenum Rated) - Verify Color	
Corning	COR-012T88-31190-A3	12 Strand OM4 Fiber Cable (ALTERNATE ONLY)	
Corning	COR-024T88-31190-A3	24 Strand OM4 Fiber Cable (ALTERNATE ONLY)	
Corning	COR-006E8P-31131-A3	6 Strand OS2 Fiber Cable (ALTERNATE ONLY)	

# GENERAL REQUIREMENTS

Contractor shall refer to specification section 270000 COMMUNICATION SYSTEMS for general project requirements. Contractor shall refer to 274100 AUDIOVISUAL SYSTEMS for AV specific notes.

# SECURITY SYSTEM

Movement of the Access Control Panel is shown for reference only, Contractor shall coordinate with Owner's Secuirty contractor to verify new placement location. All cabling rerouting of security cabling including, but not limited to, card readers, realys, etc shall be completed by the owner's security contractor.

# **CLOCK SYSTEM**

Function Summary Use Case Analog Wall Clock (POE) powered Display N/A Input N/A Audio N/A Control N/A **Special** Clock receives timing information from an existing NTP server Equipment Summarv Manufacturer Model Description SAPLING SAP-4BS-12R-0-XX 12" ROUND ANALOG CLOCK POE POWERED

	STRUCTURED CABLING SYMBOLS						
×	Data Location - Wall (X = Number of Drops, EX= Existing)						
$\frac{\nabla}{\mathbf{x}}$	Data Location - Above Counter (X = Number of Drops)						
×	Data Location - Floor (X = Number of Drops)						
((@)))	Wireless Access Point						
	Data Feed Point						
	2-post rack						
	4-post rack						
	AUDIOVISUAL SYMBOLS						
	Flat Panel Display						
HD	HDMI input plate						
TP	Touch Panel Controller						
US S <sup>X</sup>	USB Connection				<u></u>		
	Paging Ceiling Speaker (F= Flush Ceiling Mount   P= Ceiling Pende	nt Moi	unt) (	ВуС	thers	5)	
(S) (M)	Recessed Ceiling Speaker Ceiling Suspended Ceiling Microphone						
	12" Wall mounted analog clock (Coordinate height with Arch Drawin	ngs)					
<u>V</u>	Scope Delineation Matrix	0 /					
ONSI							
	SH & INSTALL	ĒR		LING	CAL	IRE	
URNI	ΗË	A	CAB	TRIC	NITU		
	LL ( (UNKNOWN AT TIME OF ISSUANCE)	GC / OTHER		DATA (	ELEO	FUR	
		GC / C		DATA (	ELECTRICAL	FUR	
	(UNKNOWN AT TIME OF ISSUANCE) Power, Back Boxes, & Conduit	C / C		DATA	X	FUR	
(ERIF)	(UNKNOWN AT TIME OF ISSUANCE)	C / C		X DATA (		FUR	
(ERIF)	Y (UNKNOWN AT TIME OF ISSUANCE) Power, Back Boxes, & Conduit Telecommunications Bonding System	9C / 0			X	FUR	
ERIFY	Y (UNKNOWN AT TIME OF ISSUANCE) Power, Back Boxes, & Conduit Telecommunications Bonding System nding of Telecommunications Racks & Devices Data Racks & Cabinets*1 Cable Tray / Wire Management	C/C		X X X	X	FUR	
Boi	Y (UNKNOWN AT TIME OF ISSUANCE) Power, Back Boxes, & Conduit Telecommunications Bonding System Inding of Telecommunications Racks & Devices Data Racks & Cabinets <sup>*1</sup> Cable Tray / Wire Management Data Cabling	C/CD		X X	X	FUR	
Boi	Y (UNKNOWN AT TIME OF ISSUANCE) Power, Back Boxes, & Conduit Telecommunications Bonding System nding of Telecommunications Racks & Devices Data Racks & Cabinets*1 Cable Tray / Wire Management	C / C		X X X X	X	FUR	>
Boi	Y (UNKNOWN AT TIME OF ISSUANCE) Power, Back Boxes, & Conduit Telecommunications Bonding System Inding of Telecommunications Racks & Devices Data Racks & Cabinets*1 Cable Tray / Wire Management Data Cabling Data Cable Labeling, Testing & Certification h Cords at Device Locations and Rack Locations Network & Phone Equipment	C / C		X X X X X X	X	FUR	)
Boi	Y (UNKNOWN AT TIME OF ISSUANCE) Power, Back Boxes, & Conduit Telecommunications Bonding System nding of Telecommunications Racks & Devices Data Racks & Cabinets <sup>*1</sup> Cable Tray / Wire Management Data Cabling Data Cable Labeling, Testing & Certification h Cords at Device Locations and Rack Locations Network & Phone Equipment UPS			X X X X X X X	X	FUR	
Boi	Y (UNKNOWN AT TIME OF ISSUANCE) Power, Back Boxes, & Conduit Telecommunications Bonding System Inding of Telecommunications Racks & Devices Data Racks & Cabinets*1 Cable Tray / Wire Management Data Cabling Data Cable Labeling, Testing & Certification h Cords at Device Locations and Rack Locations Network & Phone Equipment			X X X X X X	X	FUR	>
Boi	Y (UNKNOWN AT TIME OF ISSUANCE) Power, Back Boxes, & Conduit Telecommunications Bonding System Inding of Telecommunications Racks & Devices Data Racks & Cabinets*1 Cable Tray / Wire Management Data Cable Tray / Wire Management Data Cable Labeling, Testing & Certification In Cords at Device Locations and Rack Locations Network & Phone Equipment UPS Firestopping			X X X X X X X	X		>
Boi	Y (UNKNOWN AT TIME OF ISSUANCE) Power, Back Boxes, & Conduit Telecommunications Bonding System Inding of Telecommunications Racks & Devices Data Racks & Cabinets <sup>*1</sup> Cable Tray / Wire Management Data Cabling Data Cable Labeling, Testing & Certification h Cords at Device Locations and Rack Locations Network & Phone Equipment UPS Firestopping Conference Room Table Boxes Conference Room Table Inserts AV Equipment			X X X X X X X	X		>
Boi	Y (UNKNOWN AT TIME OF ISSUANCE) Power, Back Boxes, & Conduit Telecommunications Bonding System Inding of Telecommunications Racks & Devices Data Racks & Cabinets*1 Cable Tray / Wire Management Data Cabling Data Cable Ing, Testing & Certification In Cords at Device Locations and Rack Locations Network & Phone Equipment UPS Firestopping Conference Room Table Boxes Conference Room Table Inserts AV Equipment AV Cabling			X X X X X X X	X		> > >
Patcl	Y (UNKNOWN AT TIME OF ISSUANCE) Power, Back Boxes, & Conduit Telecommunications Bonding System Inding of Telecommunications Racks & Devices Data Racks & Cabinets*1 Cable Tray / Wire Management Data Cabling Data Cable Labeling, Testing & Certification In Cords at Device Locations and Rack Locations Network & Phone Equipment UPS Firestopping Conference Room Table Boxes Conference Room Table Inserts AV Equipment AV Cabling AV Cabling (CAT6 / UTP part of SCS)			X X X X X X X	X		> > >
/ERIFY Boi	Y (UNKNOWN AT TIME OF ISSUANCE) Power, Back Boxes, & Conduit Telecommunications Bonding System Inding of Telecommunications Racks & Devices Data Racks & Cabinets*1 Cable Tray / Wire Management Data Cabling Data Cable Ing, Testing & Certification In Cords at Device Locations and Rack Locations Network & Phone Equipment UPS Firestopping Conference Room Table Boxes Conference Room Table Inserts AV Equipment AV Cabling			X X X X X X X	X		>
ERIFY Boo Patcl	Y (UNKNOWN AT TIME OF ISSUANCE)  Power, Back Boxes, & Conduit Telecommunications Bonding System  Inding of Telecommunications Racks & Devices Data Racks & Cabinets <sup>*1</sup> Cable Tray / Wire Management Data Cabling Data Cable Labeling, Testing & Certification In Cords at Device Locations and Rack Locations Network & Phone Equipment UPS Firestopping Conference Room Table Boxes Conference Room Table Inserts AV Equipment AV Cabling AV Cabling (CAT6 / UTP part of SCS) assciated cable management shall be provided by the contractor.			X X X X X X X	X		>
ERIFY Bou Patcl	Y (UNKNOWN AT TIME OF ISSUANCE)  Power, Back Boxes, & Conduit  Telecommunications Bonding System  Inding of Telecommunications Racks & Devices  Data Racks & Cabinets <sup>*1</sup> Cable Tray / Wire Management  Data Cabling  Data Cable Labeling, Testing & Certification In Cords at Device Locations and Rack Locations Network & Phone Equipment  UPS  Firestopping  Conference Room Table Boxes  Conference Room Table Inserts  AV Equipment  AV Cabling  AV Cabling  COT6 / UTP part of SCS)  assciated cable management shall be provided by the contractor.  TECHNOLOGY SHEET LIST			X X X X X X X	X		>
ERIFY Bou Patcl	Y (UNKNOWN AT TIME OF ISSUANCE)  Power, Back Boxes, & Conduit Telecommunications Bonding System  nding of Telecommunications Racks & Devices Data Racks & Cabinets <sup>-1</sup> Cable Tray / Wire Management Data Cabling Data Cable Labeling, Testing & Certification h Cords at Device Locations and Rack Locations Network & Phone Equipment UPS Firestopping Conference Room Table Boxes Conference Room Table Boxes Conference Room Table Inserts AV Equipment AV Cabling AV Cabling CAT6 / UTP part of SCS) assciated cable management shall be provided by the contractor.  TECHNOLOGY SHEET LIST Sheet Name TECHNOLOGY FLOOR PLAN - 3RD FLOOR			X X X X X X X	X		>
ERIFY Boo Patcl	(UNKNOWN AT TIME OF ISSUANCE)      Power, Back Boxes, & Conduit      Telecommunications Bonding System      nding of Telecommunications Racks & Devices      Data Racks & Cabinets <sup>*1</sup> Cable Tray / Wire Management      Data Cabling  Data Cable Labeling, Testing & Certification      h Cords at Device Locations and Rack Locations      Network & Phone Equipment          UPS      Firestopping      Conference Room Table Boxes      Conference Room Table Inserts      AV Equipment      AV Cabling  AV Cabling (CAT6 / UTP part of SCS)      assciated cable management shall be provided by the contractor.      TECHNOLOGY SHEET LIST      ECHNOLOGY FLOOR PLAN - 3RD FLOOR      TECHNOLOGY FLOOR PLAN - 3RD FLOOR RCP			X X X X X X X	X		>
ERIFY Bou Patcl	Y (UNKNOWN AT TIME OF ISSUANCE)  Power, Back Boxes, & Conduit Telecommunications Bonding System  nding of Telecommunications Racks & Devices Data Racks & Cabinets <sup>-1</sup> Cable Tray / Wire Management Data Cabling Data Cable Labeling, Testing & Certification h Cords at Device Locations and Rack Locations Network & Phone Equipment UPS Firestopping Conference Room Table Boxes Conference Room Table Boxes Conference Room Table Inserts AV Equipment AV Cabling AV Cabling CAT6 / UTP part of SCS) assciated cable management shall be provided by the contractor.  TECHNOLOGY SHEET LIST Sheet Name TECHNOLOGY FLOOR PLAN - 3RD FLOOR			X X X X X X X	X		>
ERIFY Bor Patcl	(UNKNOWN AT TIME OF ISSUANCE)  Power, Back Boxes, & Conduit Telecommunications Bonding System nding of Telecommunications Racks & Devices Data Racks & Cabinets <sup>*1</sup> Cable Tray / Wire Management Data Cabling Data Cable Labeling, Testing & Certification h Cords at Device Locations and Rack Locations Network & Phone Equipment UPS Firestopping Conference Room Table Boxes Conference Room Table Inserts AV Equipment AV Cabling AV Cabling AV Cabling COT of / UTP part of SCS) assciated cable management shall be provided by the contractor.  TECHNOLOGY SHEET LIST Sheet Name TECHNOLOGY FLOOR PLAN - 3RD FLOOR TECHNOLOGY FLOOR PLAN - 3RD FLOOR TECHNOLOGY AUDIO-VISUAL ELEVATIONS TECHNOLOGY - RISER DIAGRAM			X X X X X X X	X		>
ERIFY Bor Patcl	(UNKNOWN AT TIME OF ISSUANCE)  Power, Back Boxes, & Conduit Telecommunications Bonding System nding of Telecommunications Racks & Devices Data Racks & Cabinets <sup>*1</sup> Cable Tray / Wire Management Data Cabling Data Cable Labeling, Testing & Certification h Cords at Device Locations and Rack Locations Network & Phone Equipment UPS Firestopping Conference Room Table Boxes Conference Room Table Inserts AV Equipment AV Cabling AV Cabling AV Cabling (CAT6 / UTP part of SCS) assciated cable management shall be provided by the contractor.  TECHNOLOGY SHEET LIST Sheet Name TECHNOLOGY FLOOR PLAN - 3RD FLOOR TECHNOLOGY FLOOR PLAN - 3RD FLOOR TECHNOLOGY AUDIO-VISUAL ELEVATIONS TECHNOLOGY AUDIO-VISUAL ELEVATIONS TECHNOLOGY DETAILS -CABLING DETAILS			X X X X X X X	X		>
/ERIFY Boi	(UNKNOWN AT TIME OF ISSUANCE)  Power, Back Boxes, & Conduit Telecommunications Bonding System nding of Telecommunications Racks & Devices Data Racks & Cabinets <sup>*1</sup> Cable Tray / Wire Management Data Cabling Data Cable Labeling, Testing & Certification h Cords at Device Locations and Rack Locations Network & Phone Equipment UPS Firestopping Conference Room Table Boxes Conference Room Table Inserts AV Equipment AV Cabling AV Cabling AV Cabling COT of / UTP part of SCS) assciated cable management shall be provided by the contractor.  TECHNOLOGY SHEET LIST Sheet Name TECHNOLOGY FLOOR PLAN - 3RD FLOOR TECHNOLOGY FLOOR PLAN - 3RD FLOOR TECHNOLOGY AUDIO-VISUAL ELEVATIONS TECHNOLOGY - RISER DIAGRAM			X X X X X X X	X		>

	CABLING SCOPE & EQUIPMEN							
	STRUCTURED CABLING SYMBOLS	6						
×	Data Location - Wall (X = Number of Drops, EX= Existing)							
×	Data Location - Above Counter (X = Number of Drops)							
×	Data Location - Floor (X = Number of Drops)							
(((0)))	Wireless Access Point							
	Data Feed Point							
	2-post rack							
	4-post rack							
	AUDIOVISUAL SYMBOLS							
	Flat Panel Display							
HD	HDMI input plate							
TP	Touch Panel Controller							
US	USB Connection	Denductor	1	<u>م</u>	41-	•		
(S) (S)	Paging Ceiling Speaker (F= Flush Ceiling Mount   P= Ceiling Recessed Ceiling Speaker	renaent Mo	unt) (	ву С	ner	5)		
(S) (M)	Ceiling Suspended Ceiling Microphone							
	12" Walll mounted analog clock (Coordinate height with Arch	Drawings)						
¥	Scope Delineation Matrix							
SPONSI							Σ	
	SH & INSTALL	ĒR		DATA CABLING	CAL	JRE	OWNERS IT TEAM	
- FURNI - INSTAI		GC / OTHER	A	(CAB	ELECTRICAL	FURNITURE		
	LL Y (UNKNOWN AT TIME OF ISSUANCE)	CO		DATA		FUF		
	Power, Back Boxes, & Conduit				X			
Во	Telecommunications Bonding System nding of Telecommunications Racks & Devices			x	X			
	Data Racks & Cabinets <sup>*1</sup>			x			>	
	Cable Tray / Wire Management			Х				
	Data Cabling			X				
	Data Cable Labeling, Testing & Certification h Cords at Device Locations and Rack Locations			X X				
1 410	Network & Phone Equipment						×	
	UPS						>	
	Firestopping			X				
	Conference Room Table Boxes Conference Room Table Inserts					X X	-	
	AV Equipment		x				>	
	AV Cabling		x					
	AV Cabling (CAT6 / UTP part of SCS)			x				
ost racks and	assciated cable management shall be provided by the contractor.							
Sheet								
0	TECHNOLOGY COVER SHEET TECHNOLOGY FLOOR PLAN - 3RD FLOOR							
1	TECHNOLOGY FLOOR PLAN - 3RD FLOOR RC	P						
0	TECHNOLOGY ENLARGED ROOM PLANS - NE	EW						
)1	TECHNOLOGY AUDIO-VISUAL ELEVATIONS							
2	TECHNOLOGY - RISER DIAGRAM							
0	TECHNOLOGY DETAILS -CABLING DETAILS TECHNOLOGY AUDIOVISUAL SIGNAL FLOW							
I	TECHNOLOGY AUDIOVISUAL SIGNAL FLOW							
2								
2  01	<b>TECHNOLOGY DEMOLITION PLAN - 3RD FLO</b>	OR						

#### REVISIONS:

ISSUE	DATE
50% DESIGN DEVELOPMENT	02.01.2023
100% DESIGN DEVELOPMENT	04.10.2023
50% CONSTRUCTION DOCUMENTS	05.08.2023
BID SET	06.05.2023
CONSTRUCTION	08.11.2023

#### PROJECT:

#### SKOKIE PUBLIC LIBRARY 3rd FLOOR 5215 OAKTON STREET SKOKIE, IL 60077

#### ARCHITECT:

ANDREW BERMAN ARCHITECT PLLC 77 CHAMBERS STREET NEW YORK, NY 10007 P 212 226 5998

#### MEP ENGINEER:

#### SALAS O'BRIEN

815 SOUTH WABASH AVENUE CHICAGO, ILLINOIS 60605 P 312 786 4310 LIGHTING DESIGNER:

#### SCHULER SHOOK

363 WEST ERIE, SUITE 400 CHICAGO, ILLINOIS 60604 P 312 944 8230

#### ACOUSTICAL CONSULTANT:

### THRESHOLD ACOUSTICS LLC

141 WEST JACKSON BLVD, SUITE CHICAGO, ILLINOIS 60604 P 312 386 1400


#### SHEET TITLE:

#### TECHNOLOGY COVER SHEET

SCALE: DRAWN: AG SEAL:

DATE: CHECKED: JG SHEET NO .:

T000

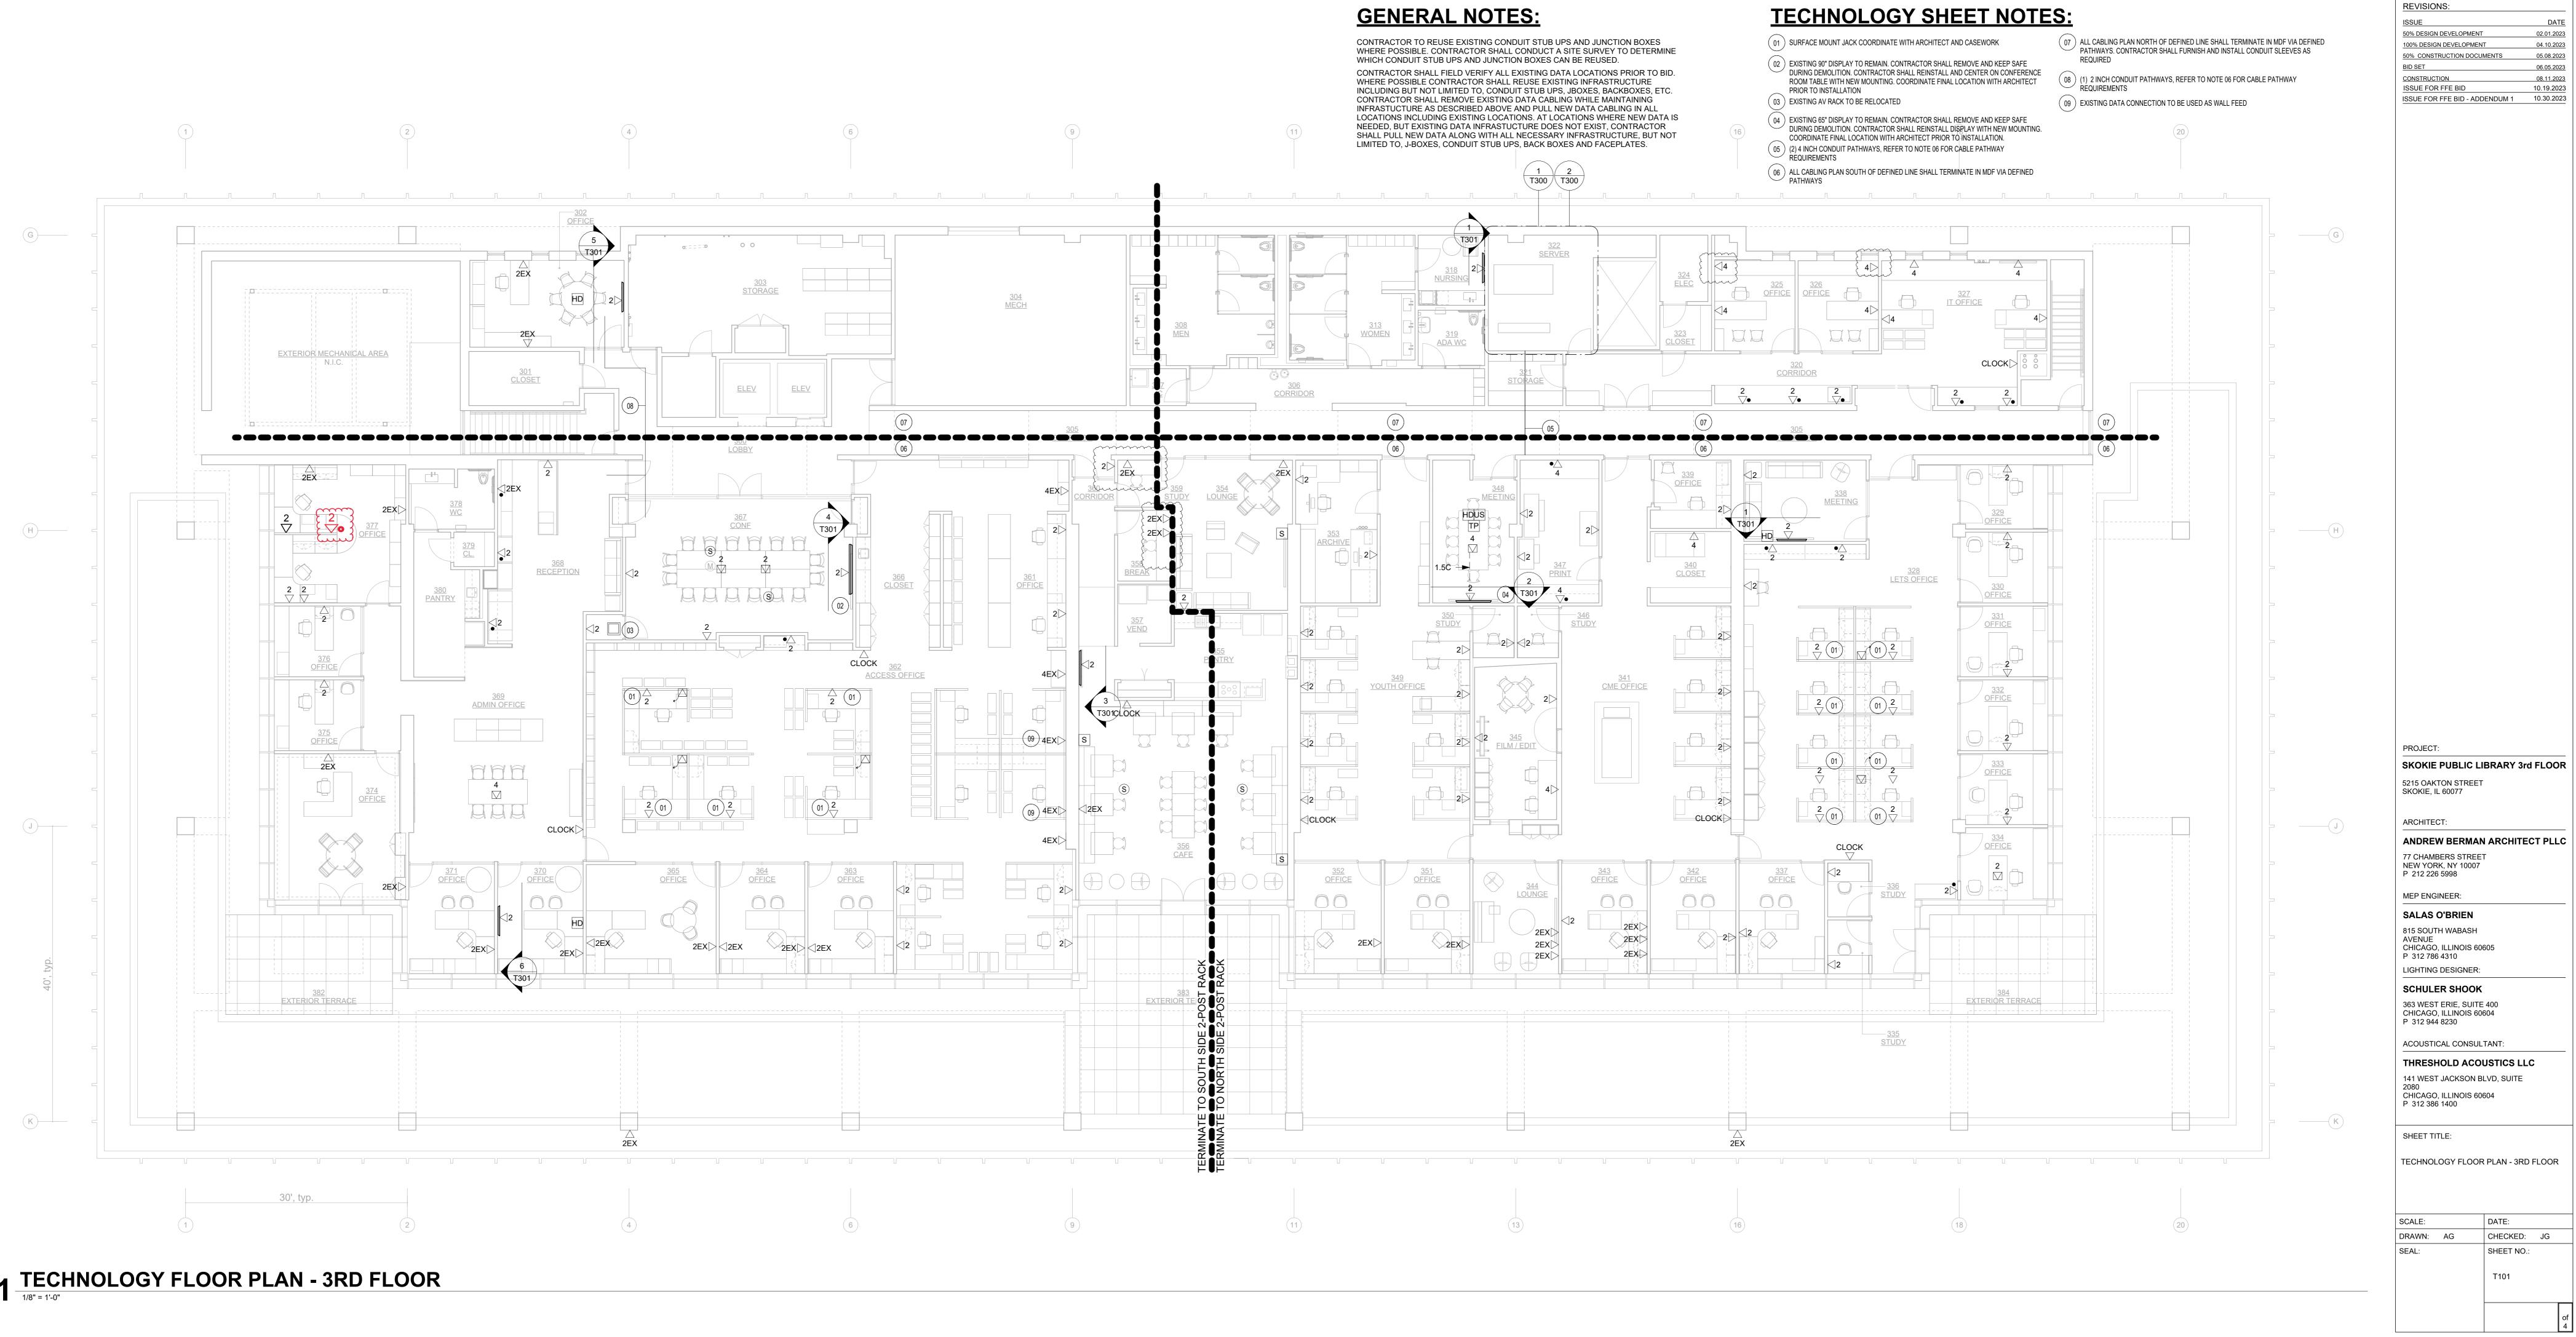

# **GENERAL NOTES:**

# **TECHNOLOGY SHEET NOTES:**

COPYRIGHT V ANDREW BERMAN ARCHITECT PLLC